




insight
design

1900 N. Bayshore
Drive - #204-A
Miami, Florida
3 3 1 3 2
305.545.4964

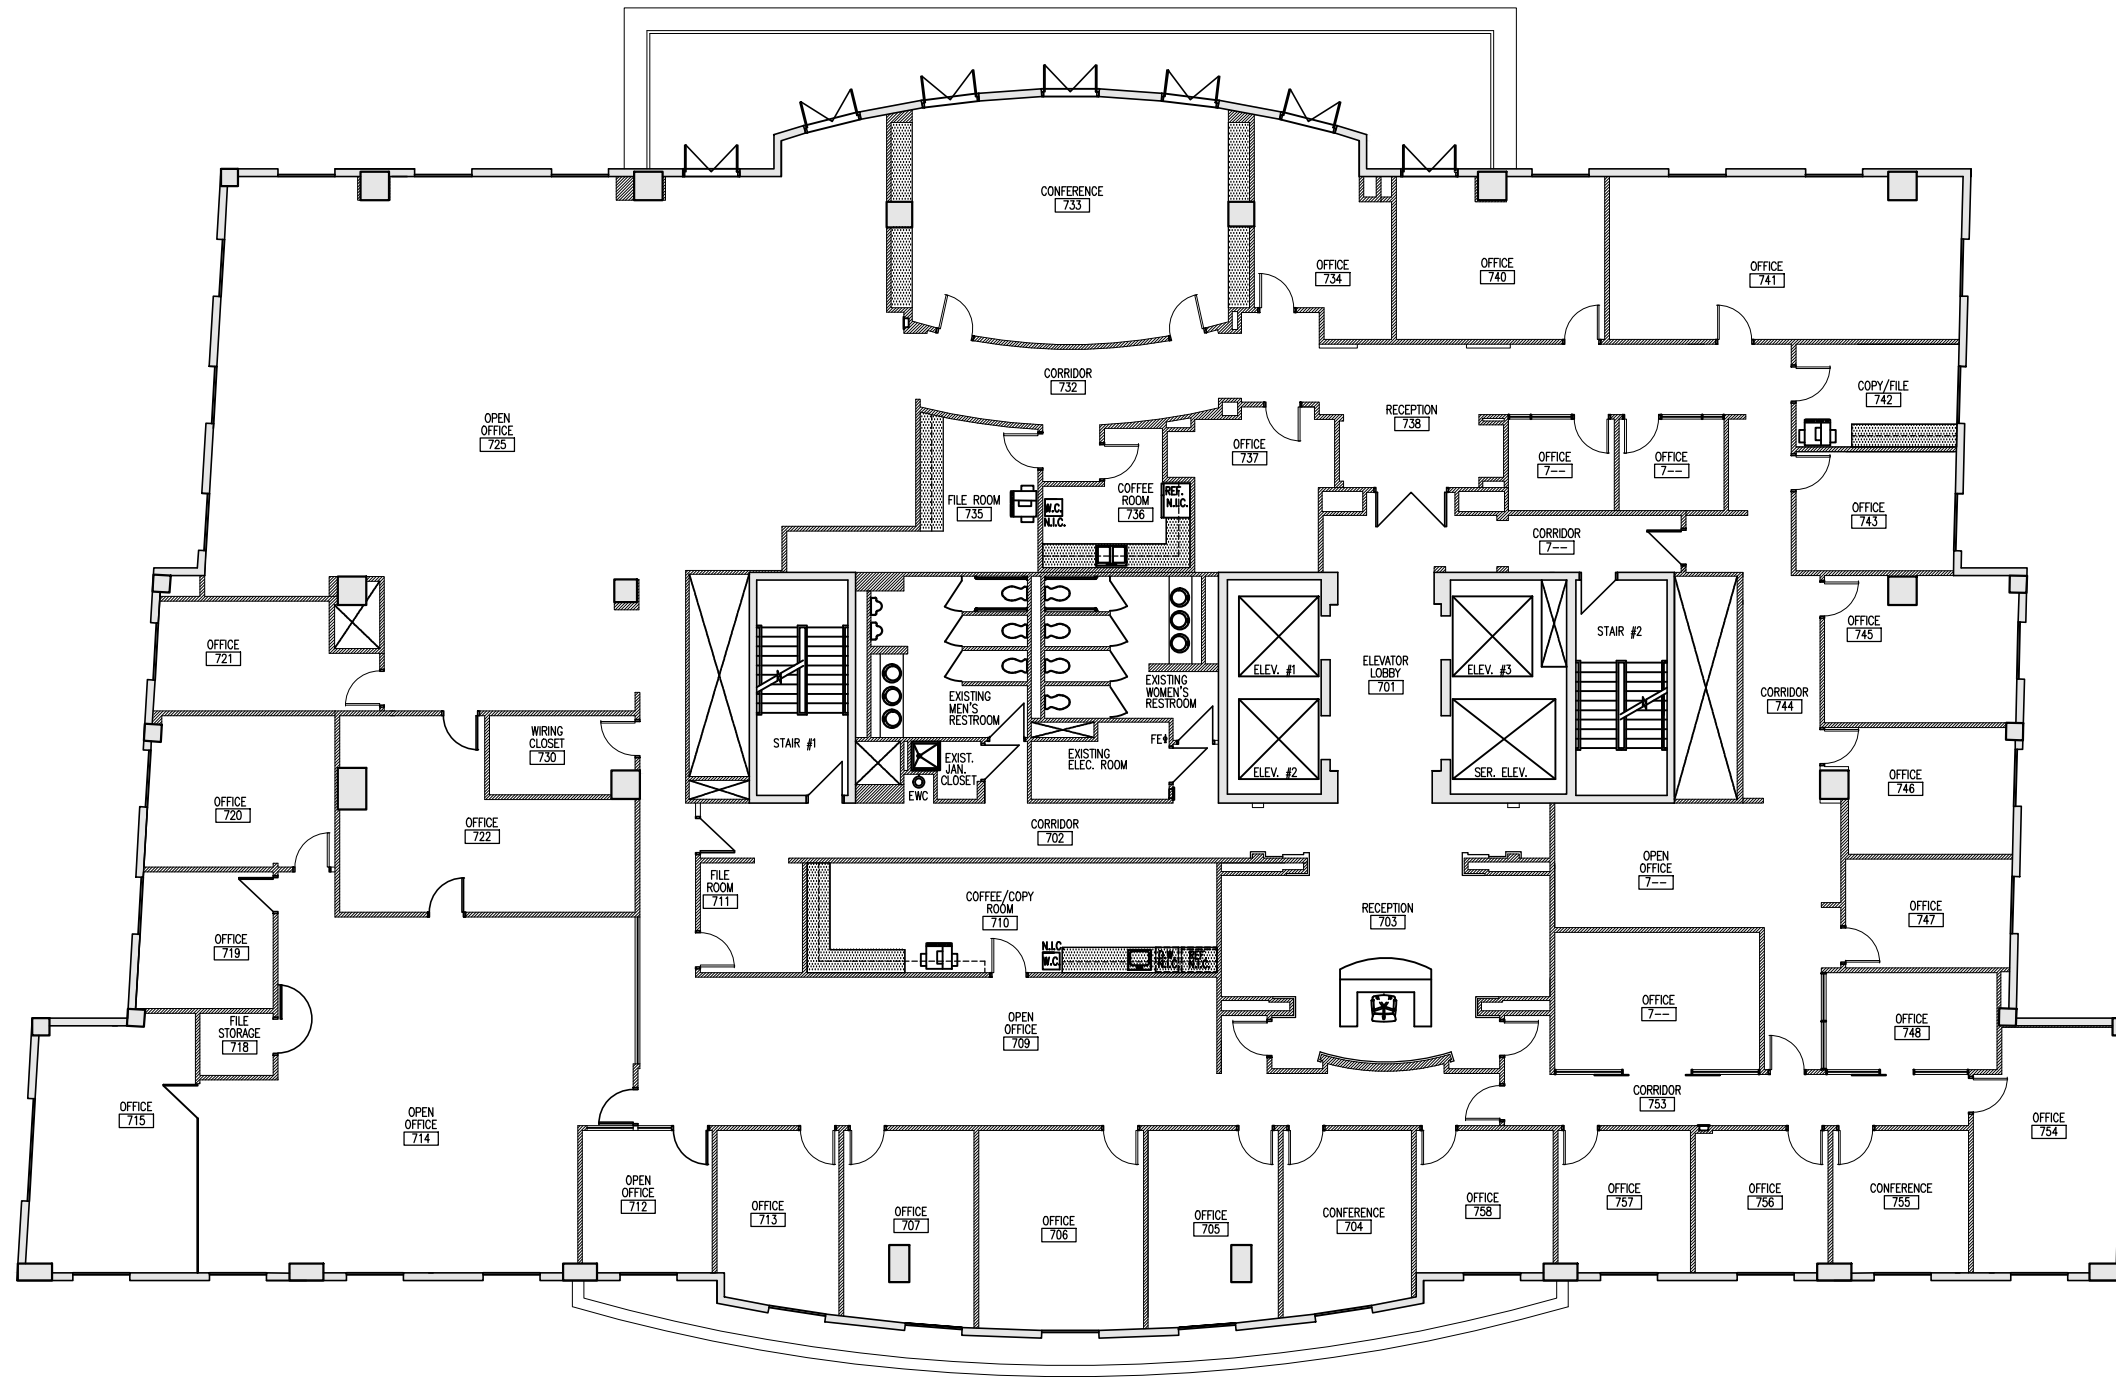

1 AS BUILT PLAN
SK-2 7th FLOOR PLAN

SCALE: 1/16"=1'-0"



PROJECT NO:	1514-00
DRAWN BY:	AM
DATE:	06-08-2021
SCALE:	
SHEET NO:	SK-2