




insight
design


2930 Northeast
2nd Court
Miami, Florida
33137
305.545.4964

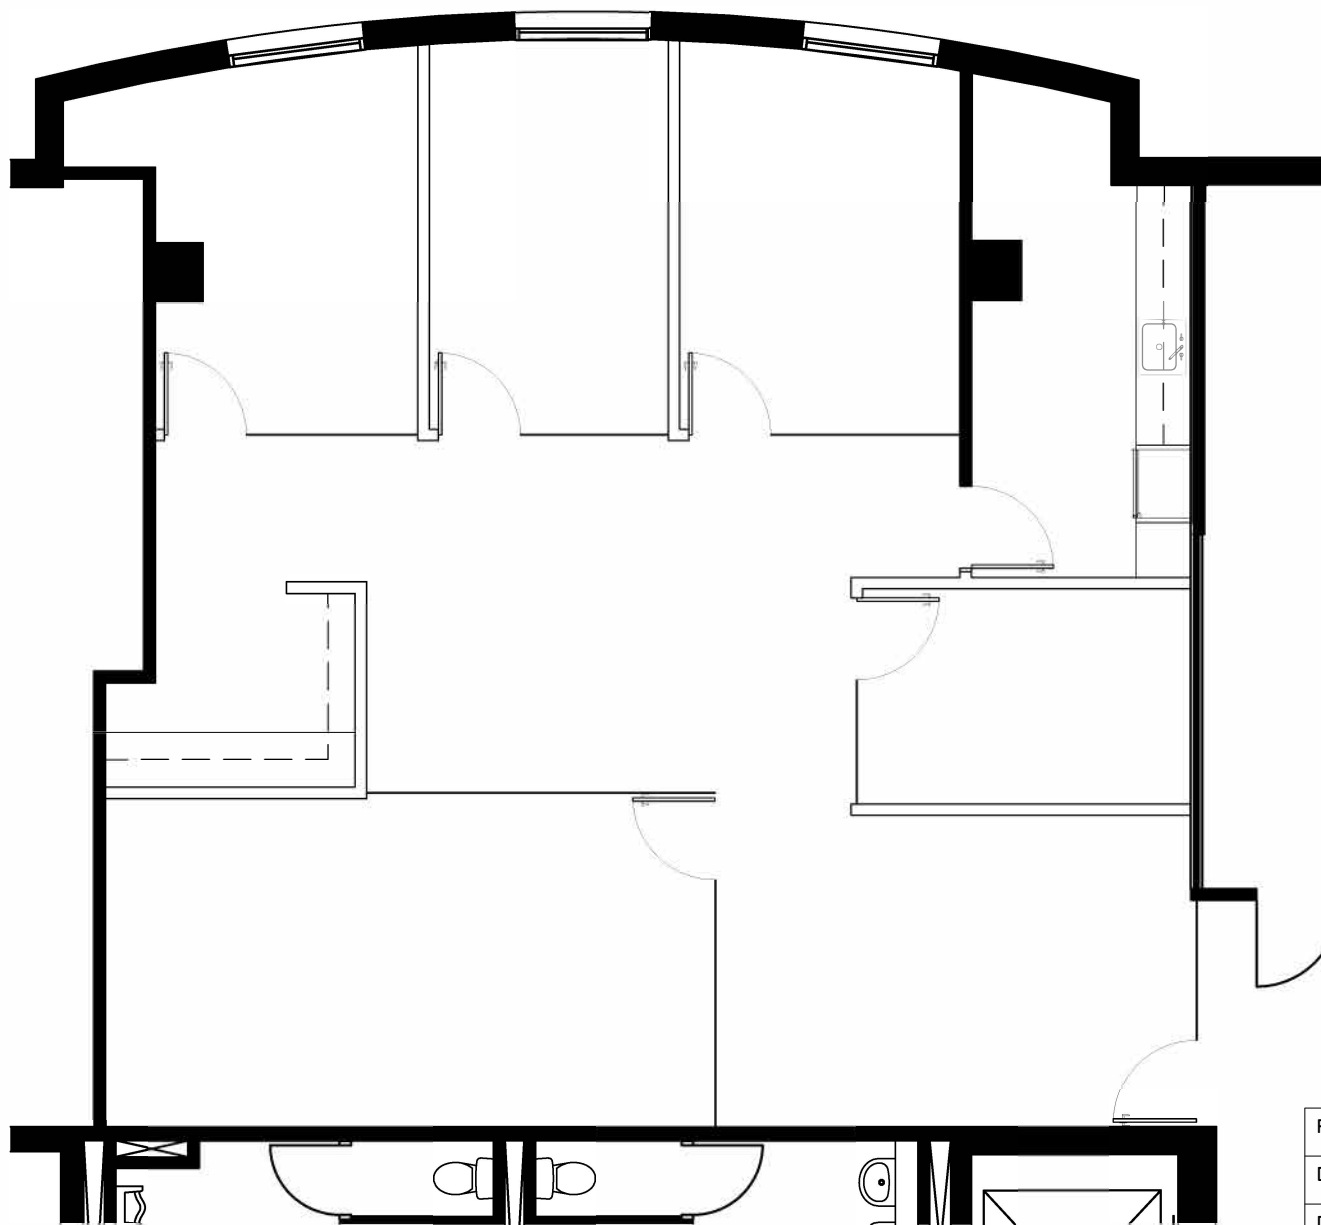

BAC Colonnade AT 2333 PONCE DE LEON

As-Built Plan / Suite 920

N.T.S.

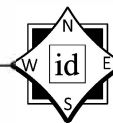

PROJECT NO:	1514-04
DRAWN BY:	IM
DATE:	
SCALE:	N.T.S.
SHEET NO:	SK-1